


PUBLIC CORRIDOR

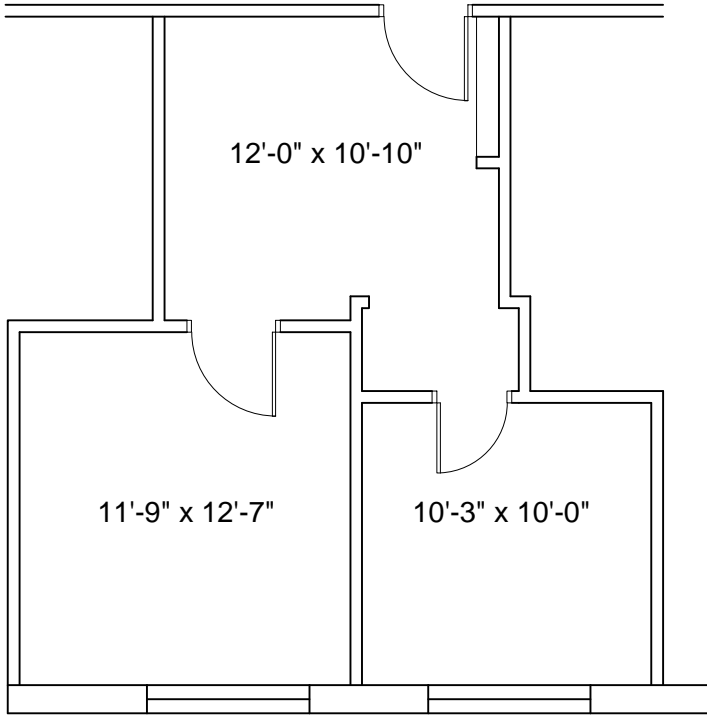

VILLAGE GREEN
850 BOYCE ROAD
SUITE 10
AS-BUILT PLAN