


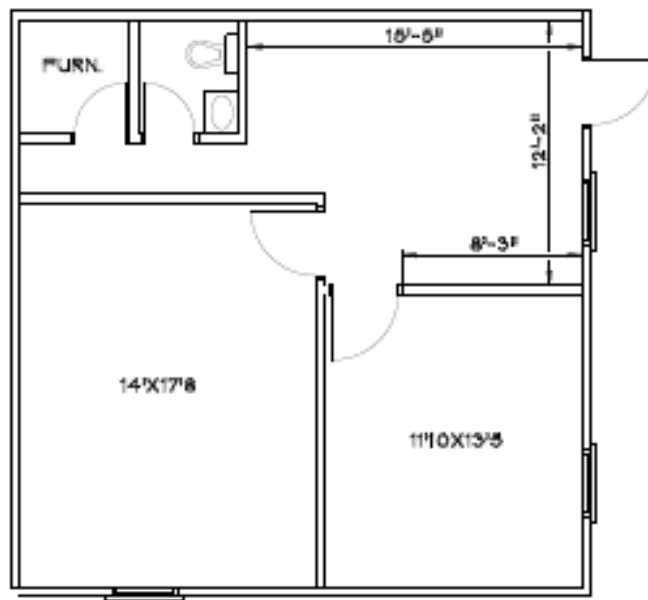

St. Claire Plaza
Suite 1400