


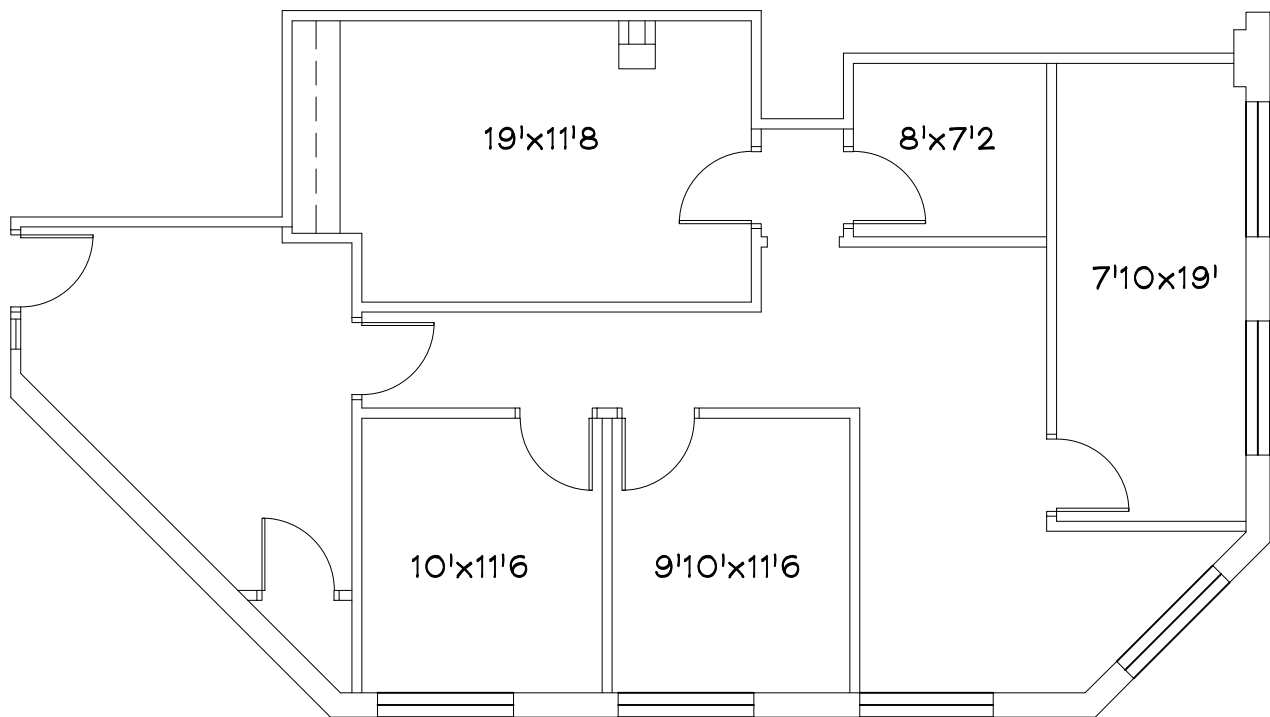

EXECUTIVE COMMONS
SUITE 100
AS-BUILT PLAN