


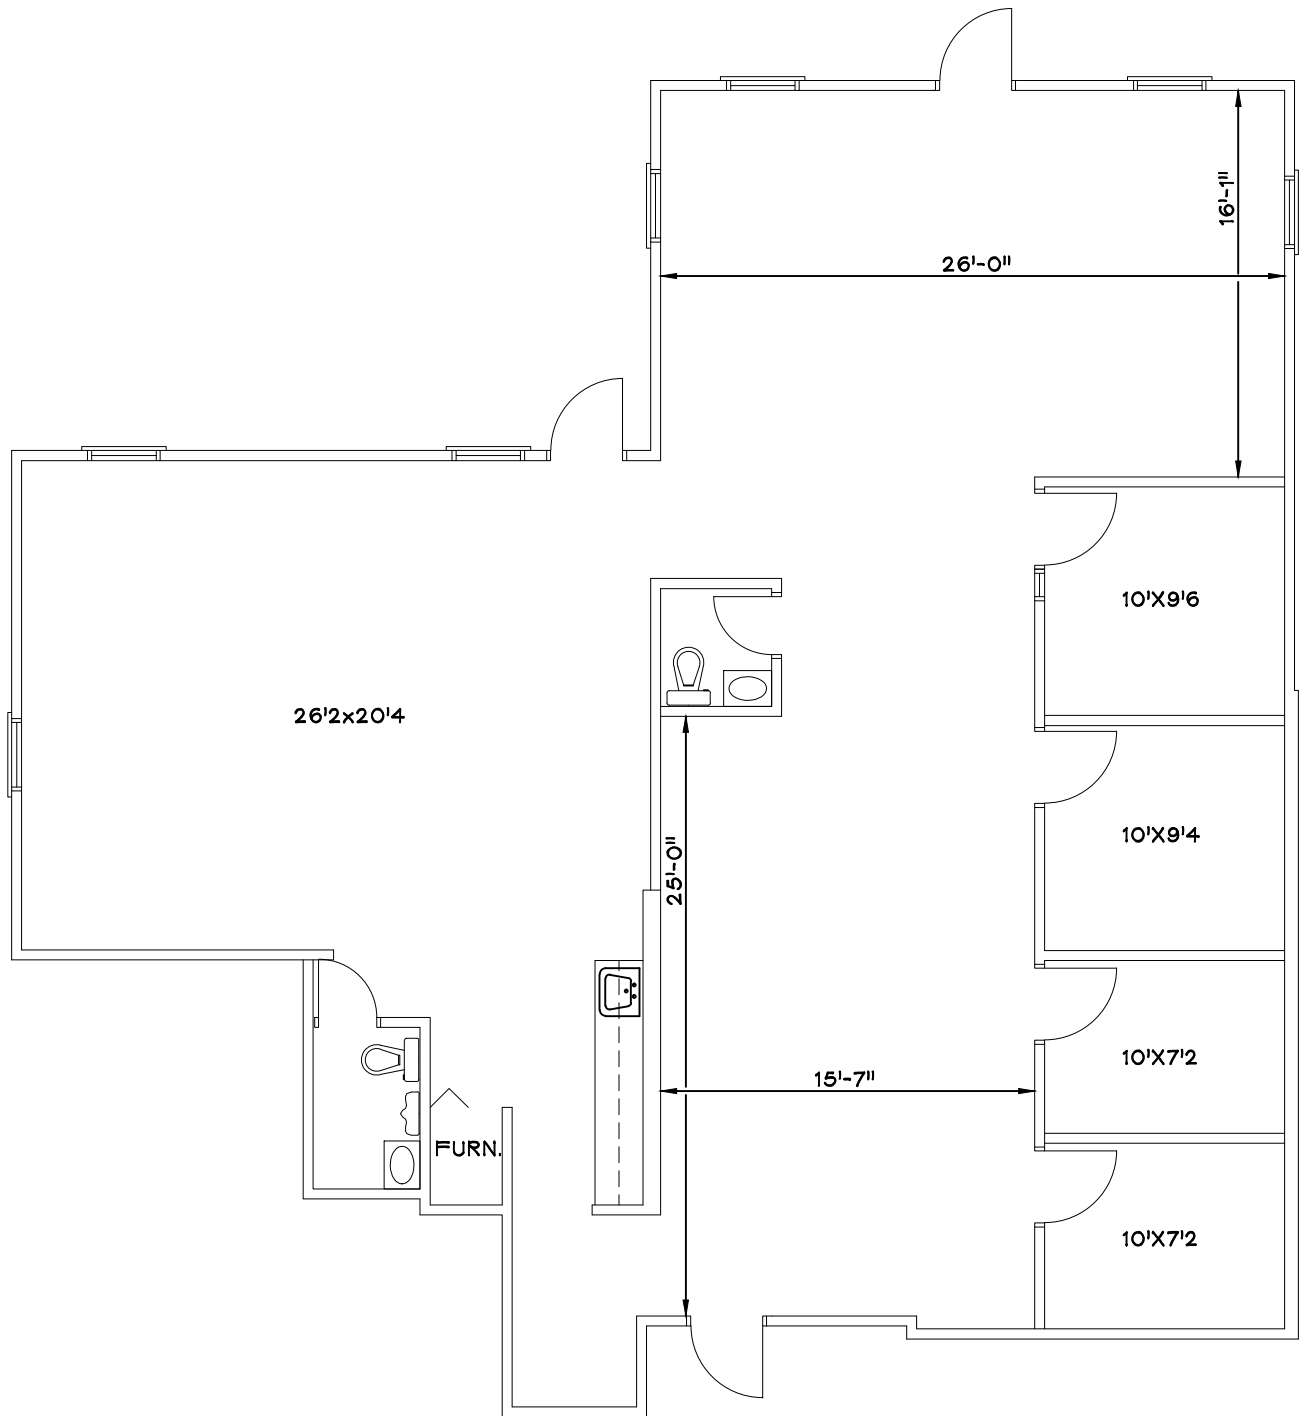

St. Claire Plaza
Suite 200