


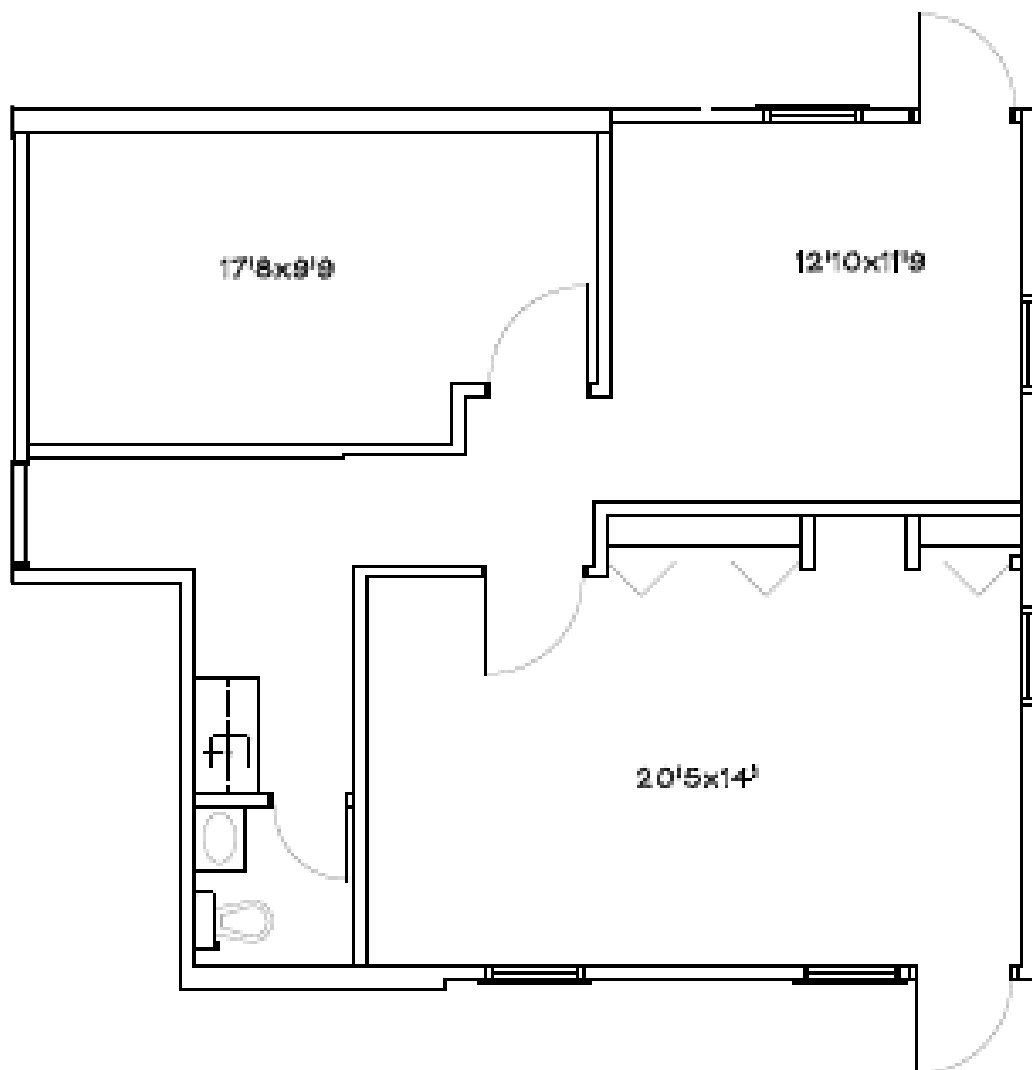

ST. CLAIRE PLAZA

SUITE 2050