


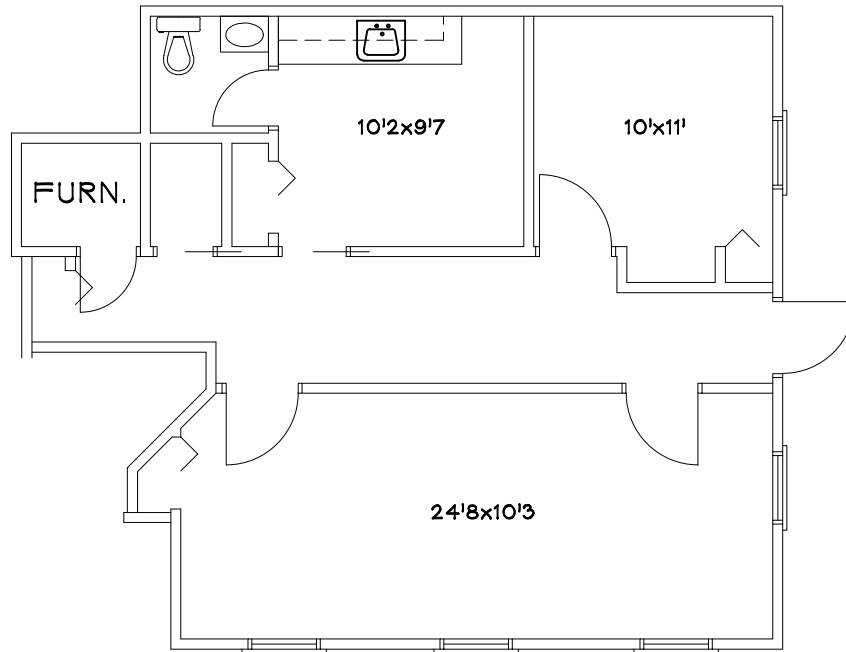

St. Claire Plaza
Suite 2700B