


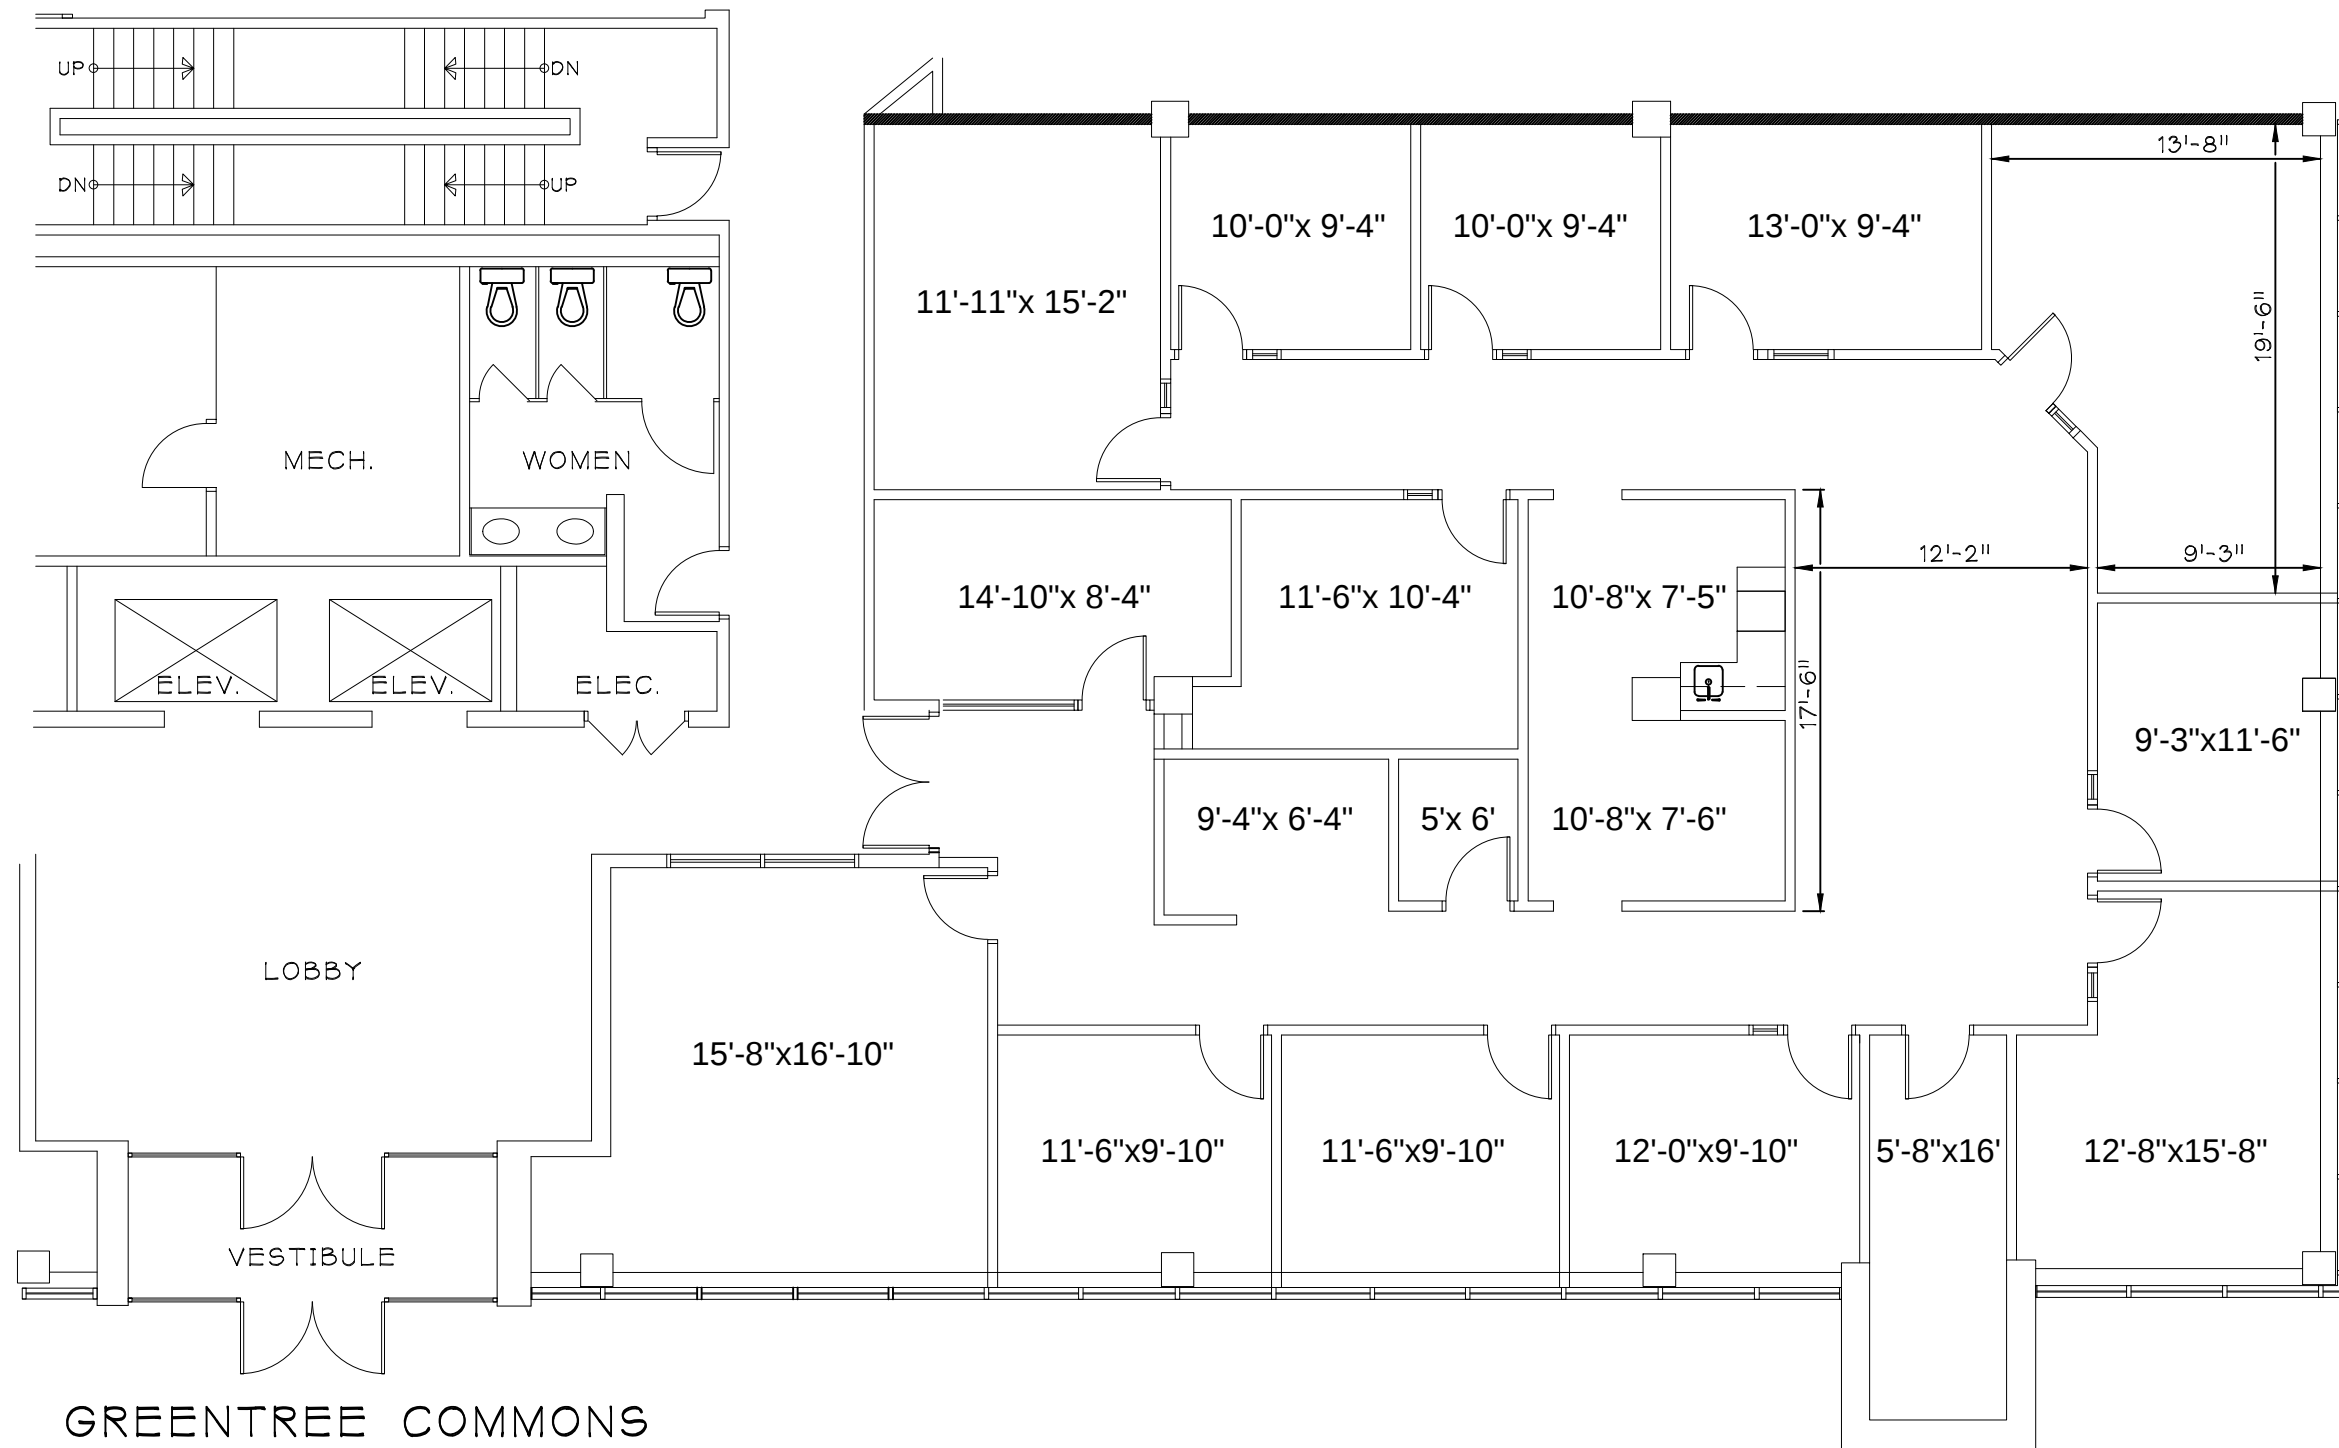

GREENTREE COMMONS
FIRST FLOOR - SUITE 100