


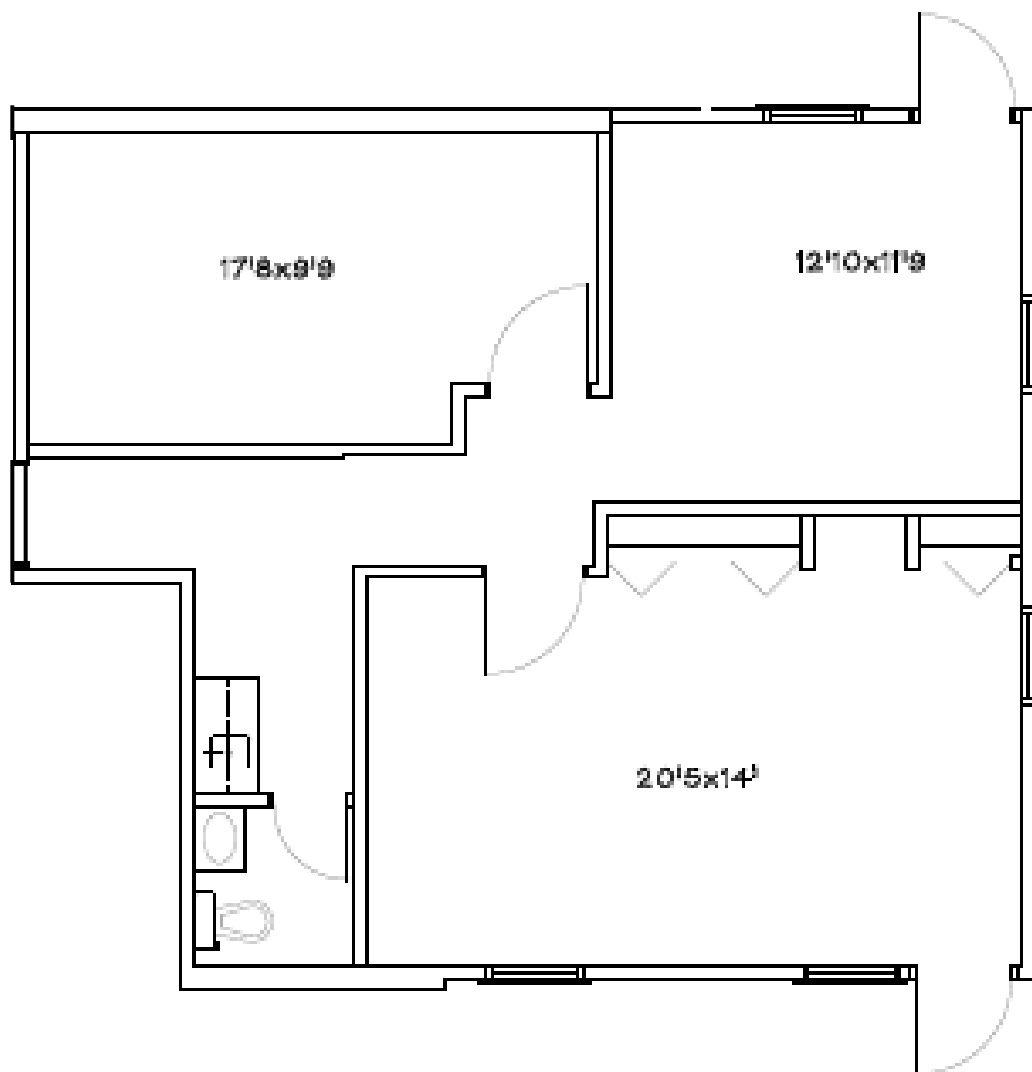

ST. CLAIRE PLAZA
SUITE 2050