


Exhibit "A"
Floor Plan

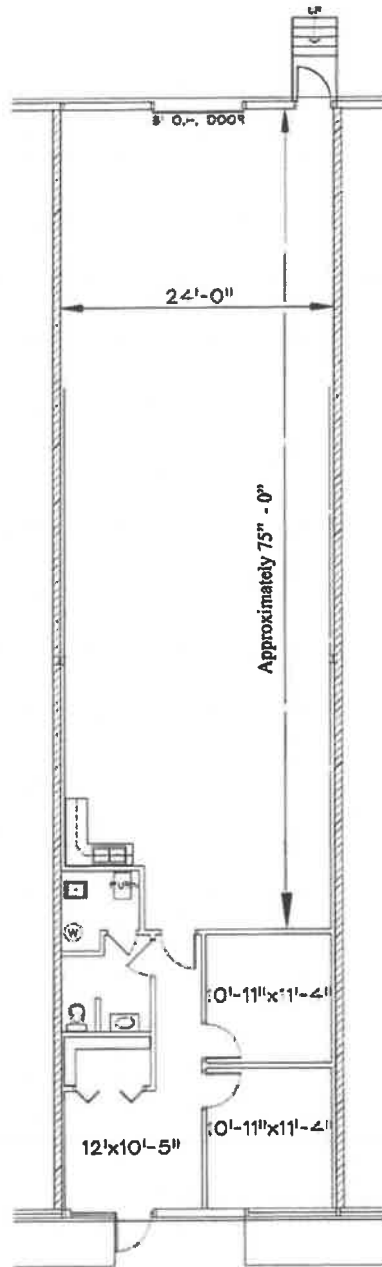

Unit 3251-C

2,400 sq. ft.