


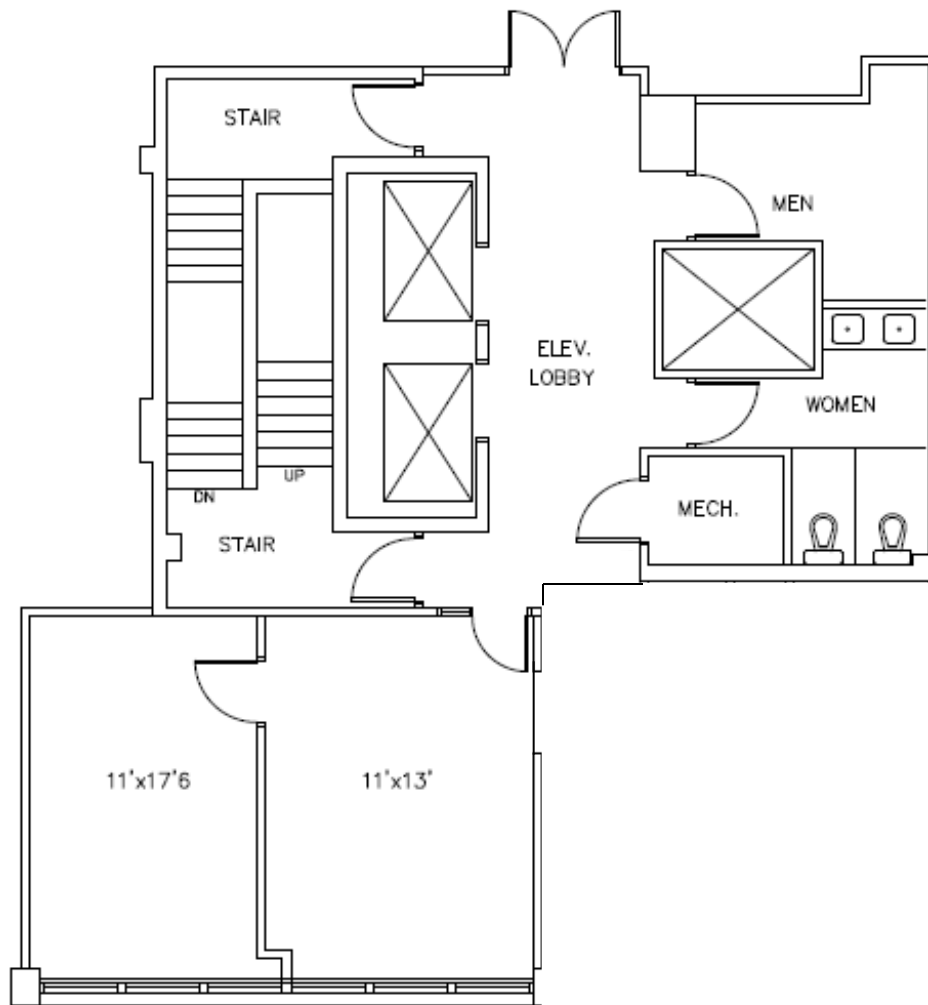

SOUTHMARK BUILDING

FOUTH FLOOR – SUITE 401

504 sq. ft.